

**HUNT MICHEL & PARTNERS**  
 24 DARLING STREET  
 IPSWICH Q 4305  
 PH 3812 2399

CONSULTING CHARTERED ENGINEERS  
 CIVIL AND STRUCTURAL  
 A.B.N. 75 074 746 599

CLIENT  
 ROSEWOOD GREEN PROPERTY  
 PO BOX 3715  
 ROUSE HILL NSW 2155

PROJECT  
 "ROSEWOOD GREEN ESTATE"  
 STAGE 1A


DRAWING TITLE  
 AS-CONSTRUCTED SERVICES  
 LOTS 1-7 & 22-26

REV	DATE	APPROVED:
		<i>Daniel Michel</i>
		DANIEL MICHEL RPEQ 3766 DIRECTOR HUNT MICHEL & PARTNERS

DESIGNED: D.M.  
 DRAWN: N.K.  
 CHECKED: D.M.  
 SCALE: 1:500 AT A3  
 DATE:

JOB No.  
 208025

DWG No.  
 AC4

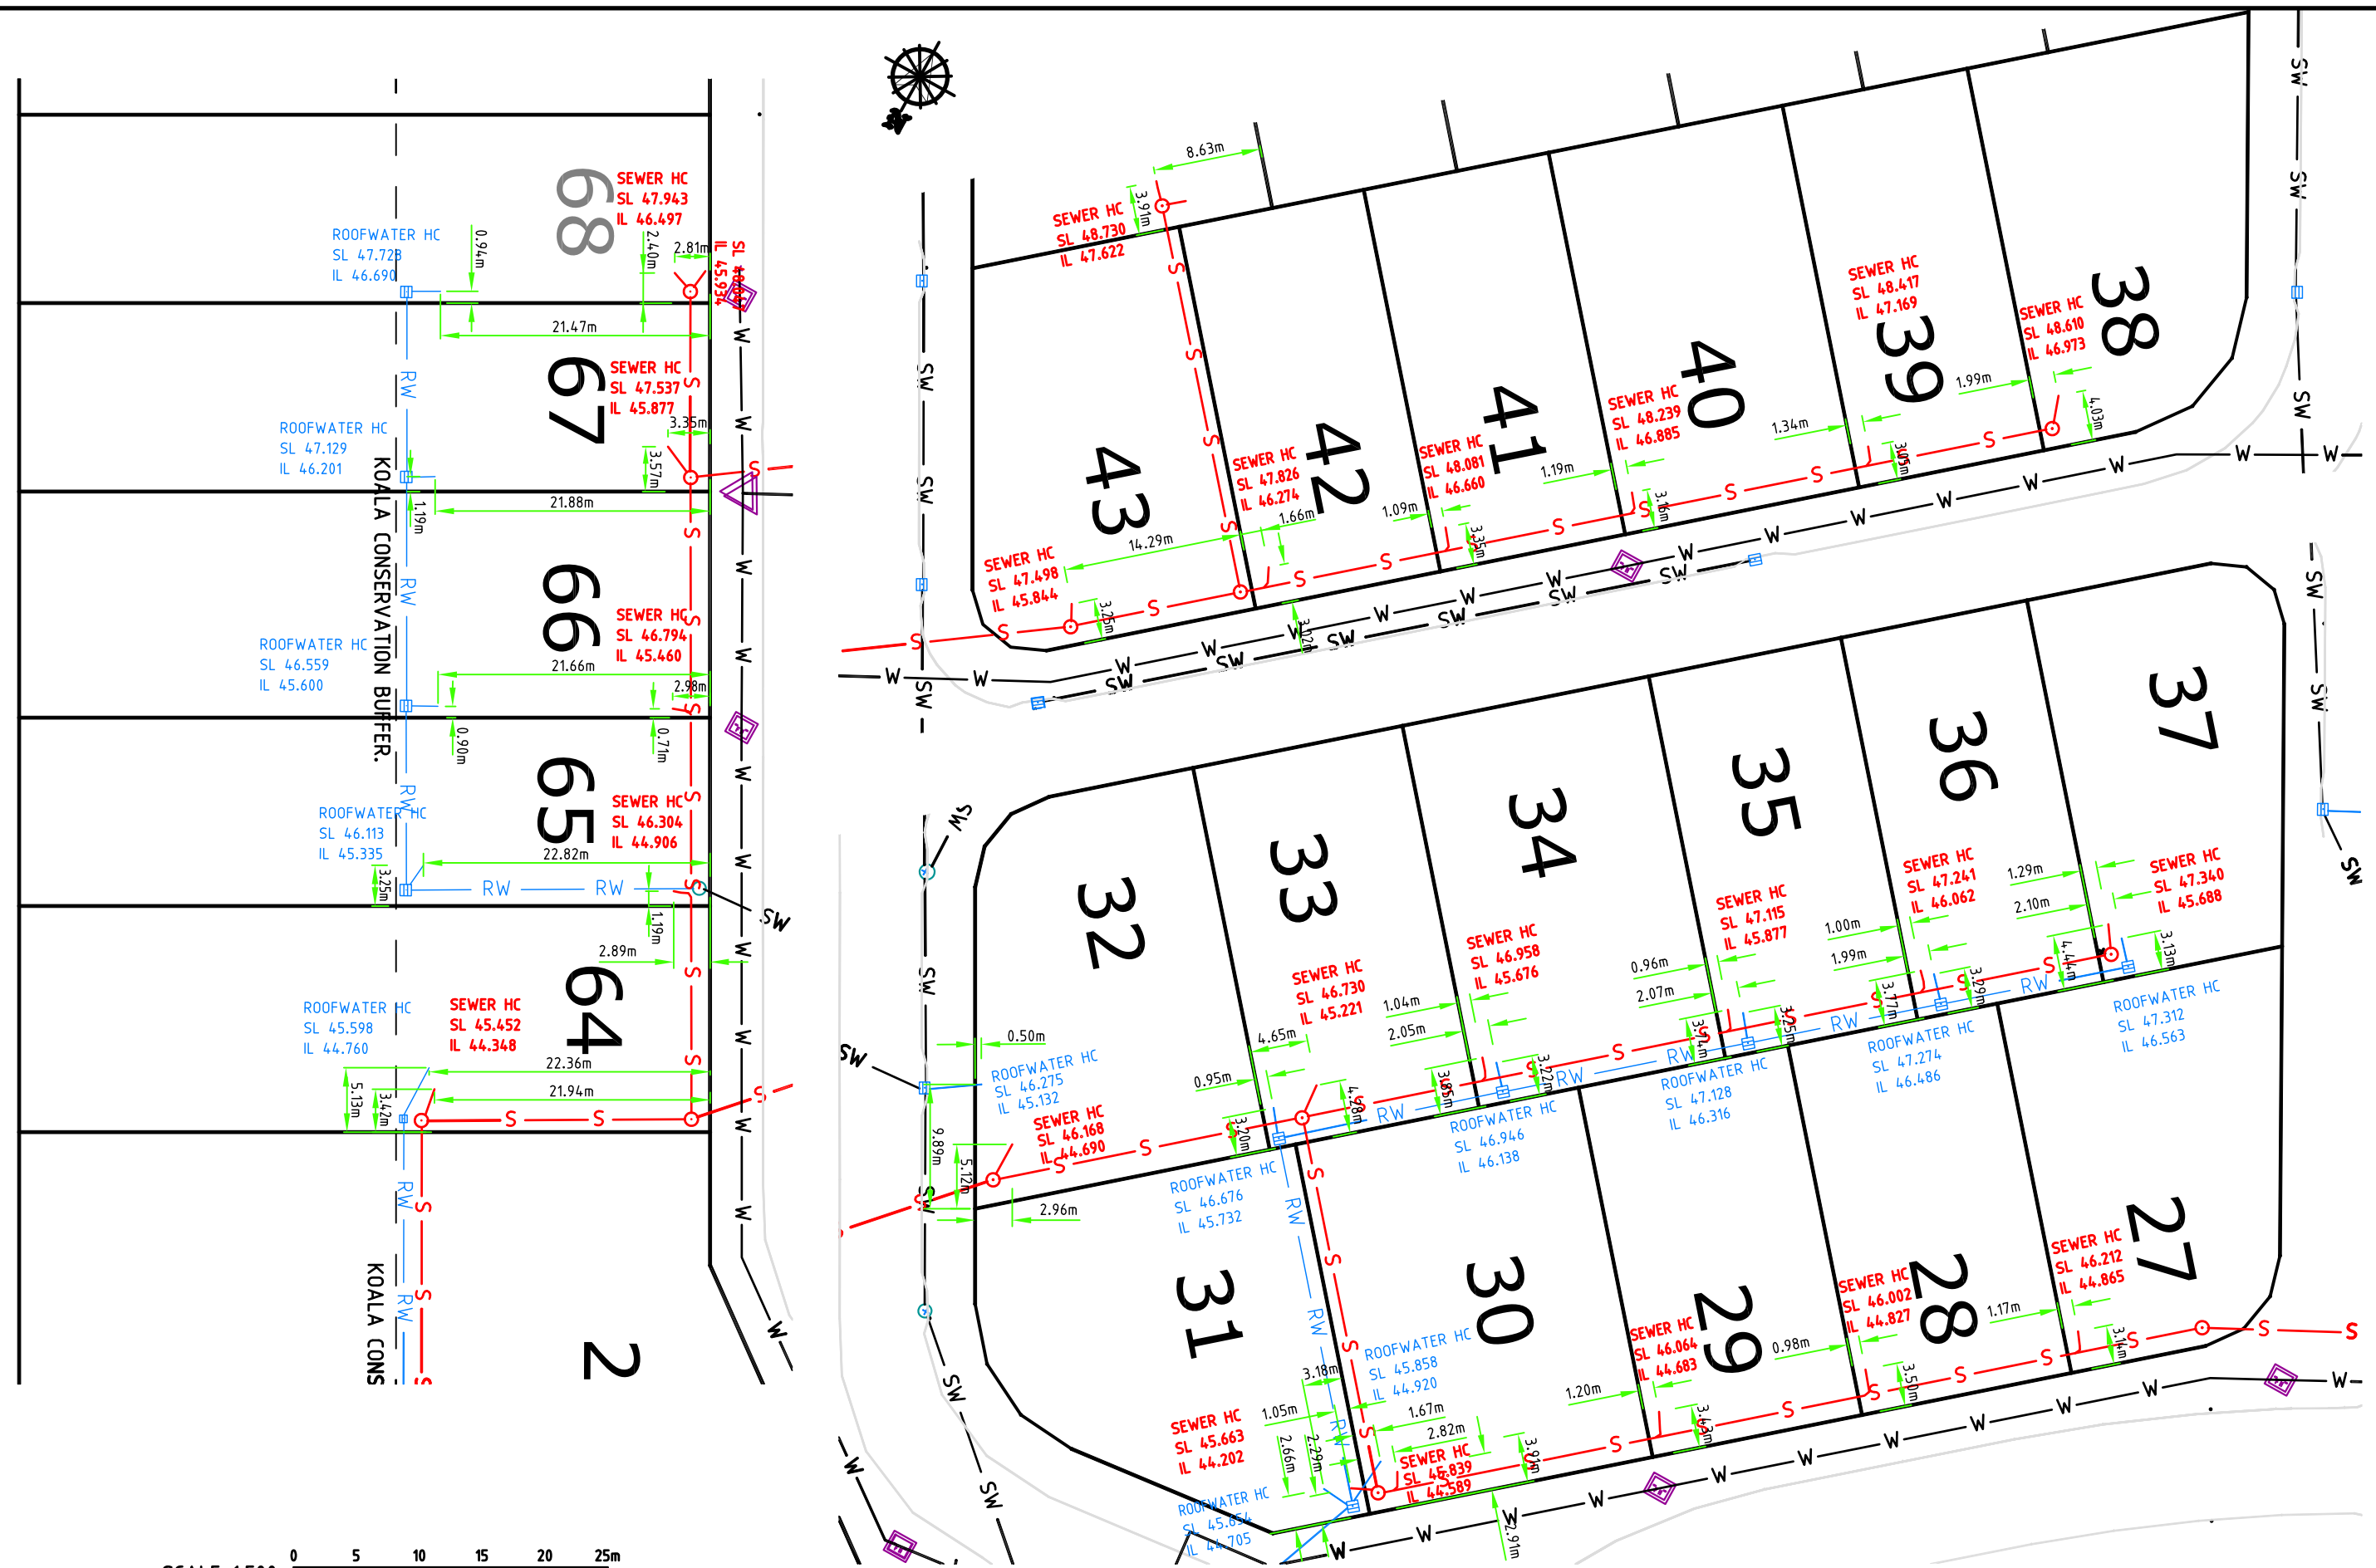

SCALE 1:500

**HUNT MICHEL & PARTNERS**  
 24 DARLING STREET  
 IPSWICH Q 4305  
 PH 3812 2399

CONSULTING CHARTERED ENGINEERS  
 CIVIL AND STRUCTURAL  
 A.B.N. 75 074 746 599

CLIENT  
 ROSEWOOD GREEN PROPERTY  
 PO BOX 3715  
 ROUSE HILL NSW 2155

PROJECT  
 "ROSEWOOD GREEN ESTATE"  
 STAGE 1A


DRAWING TITLE  
 AS-CONSTRUCTED SERVICES  
 LOTS 27-43 & 64-67

REV	DATE

APPROVED:  
*Daniel Michel*  
 DANIEL MICHEL RPEQ 3766  
 DIRECTOR  
 HUNT MICHEL & PARTNERS

DESIGNED: D.M.  
 DRAWN: N.K.  
 CHECKED: D.M.  
 SCALE: 1:500 AT A3  
 DATE: 23.17

JOB No.  
 208025  
 DWG No.  
 AC3

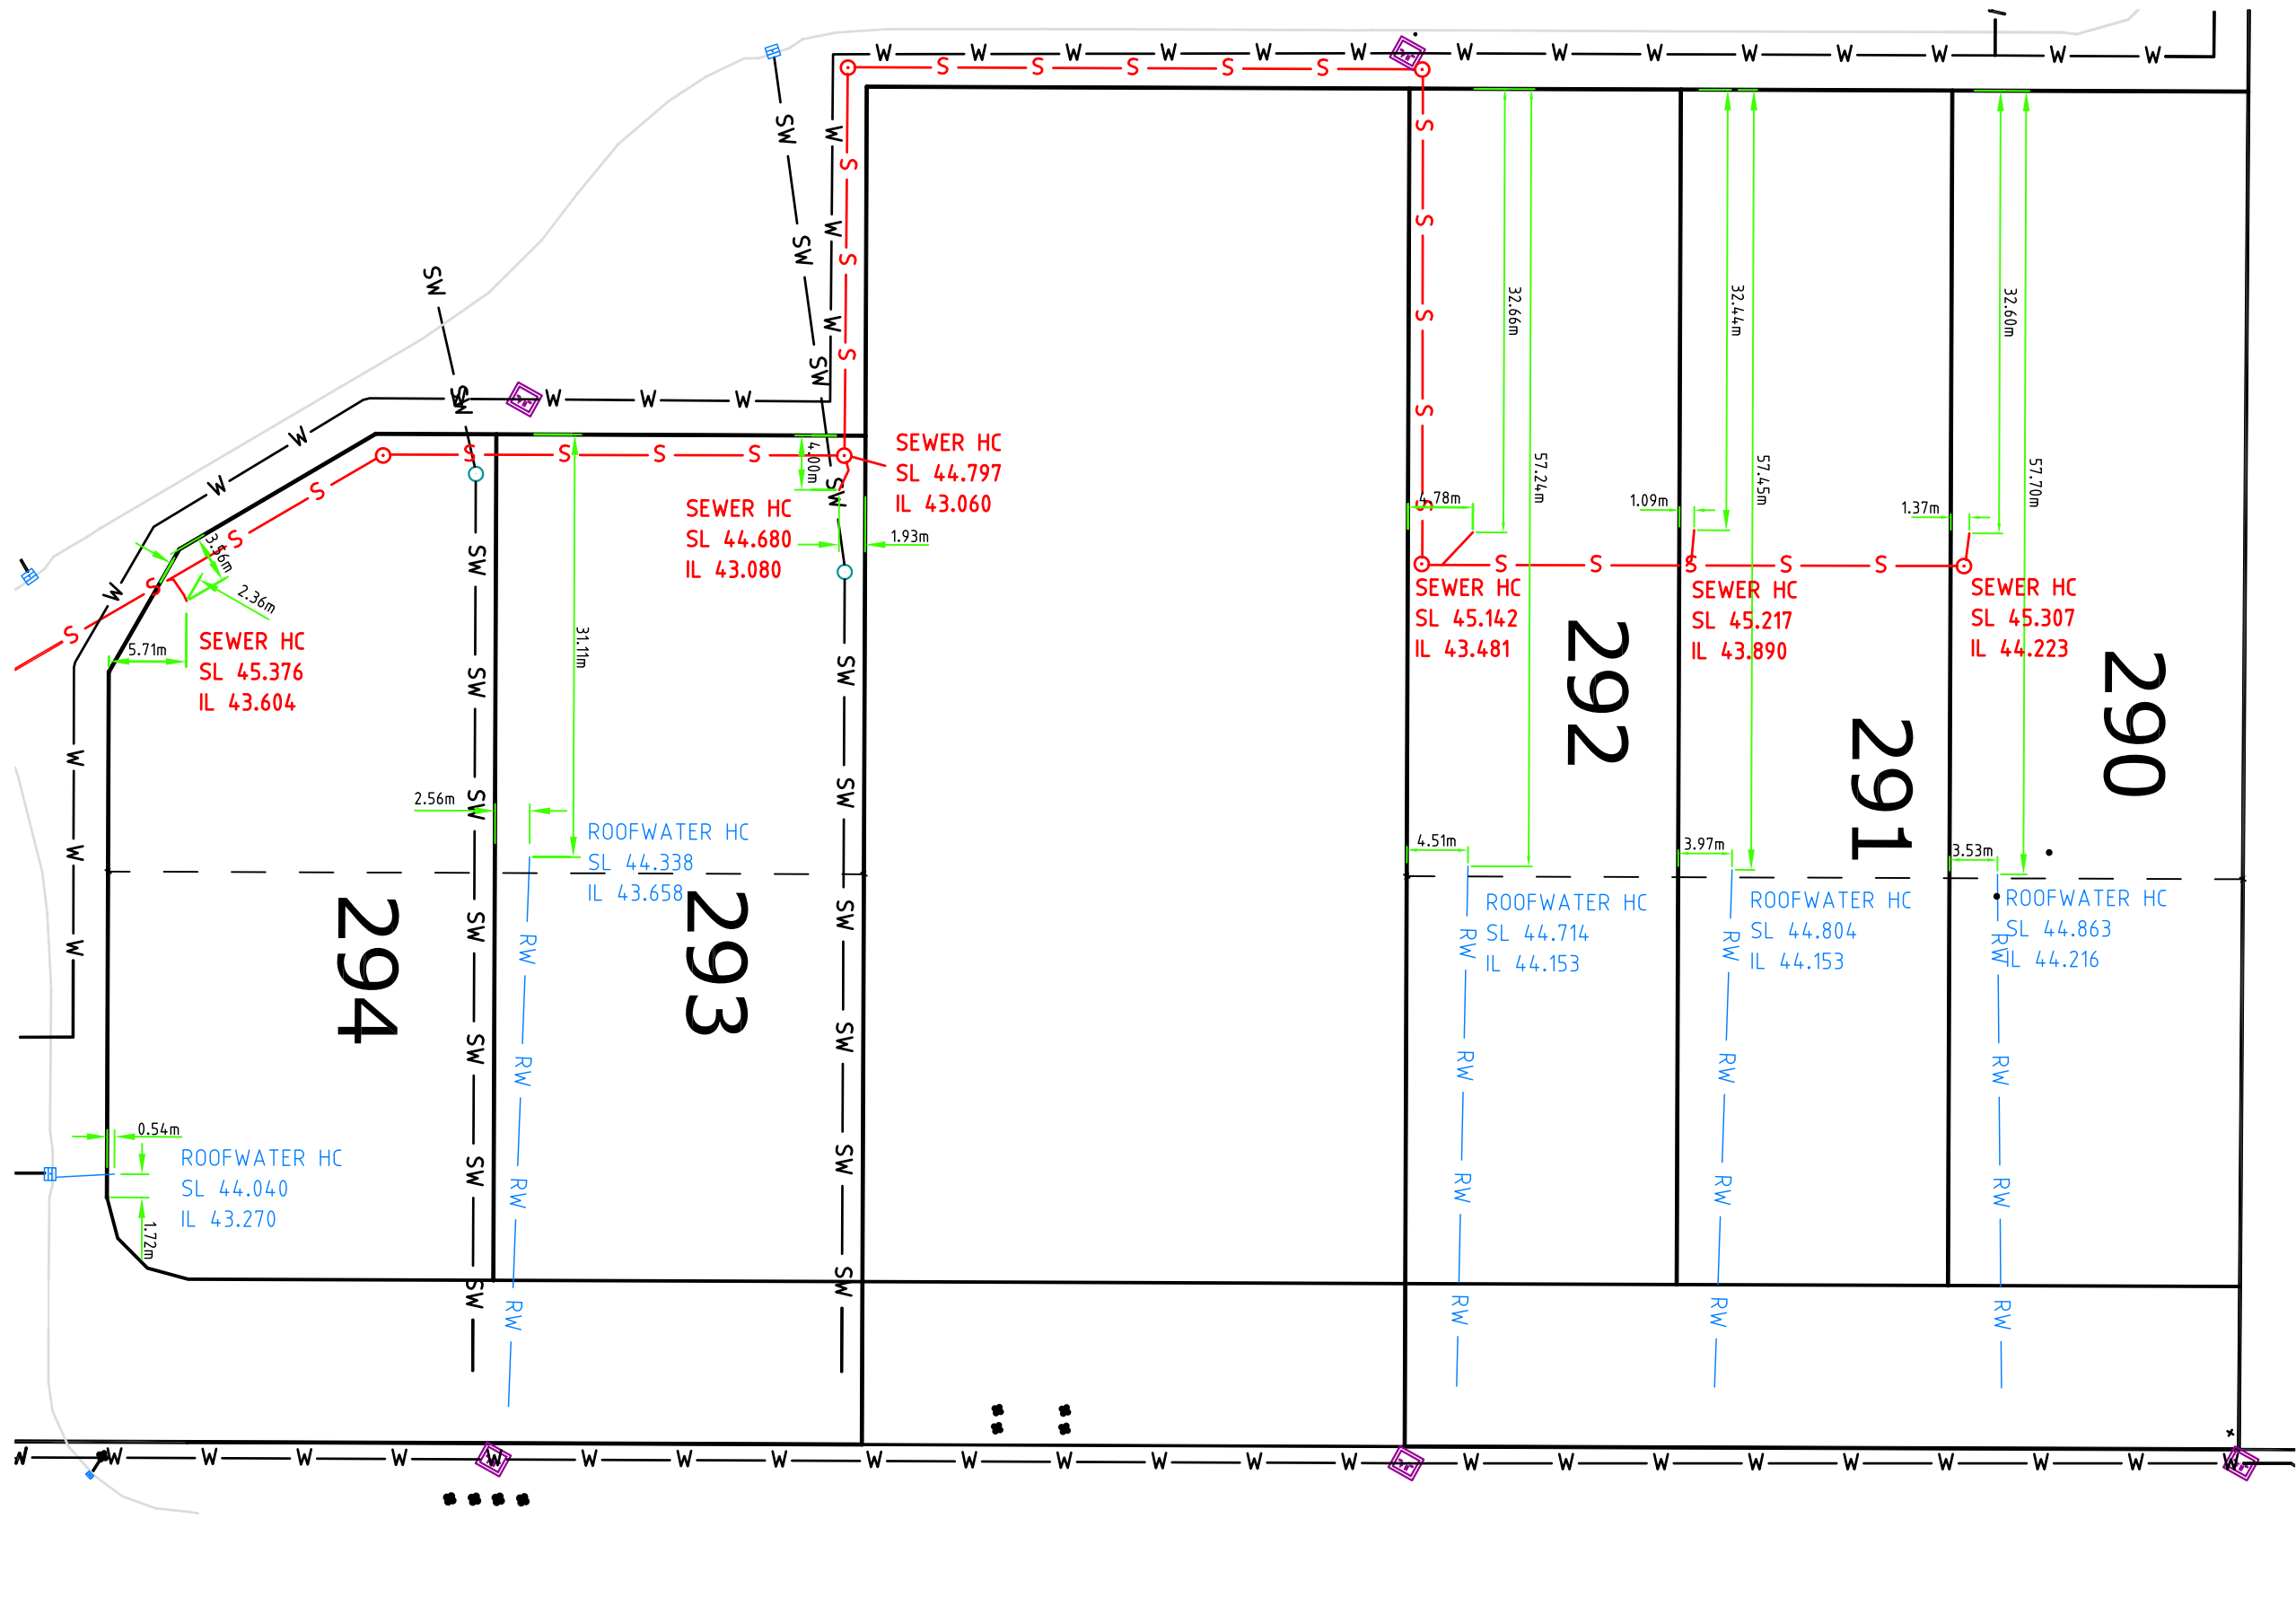

SCALE 1:500

**HUNT MICHEL & PARTNERS**

24 DARLING STREET  
IPSWICH Q 4305  
PH 3812 2399

CONSULTING CHARTERED ENGINEERS  
CIVIL AND STRUCTURAL  
A.B.N. 75 074 746 599

CLIENT  
ROSEWOOD GREEN PROPERTY  
PO BOX 3715  
ROUSE HILL NSW 2155



PROJECT  
"ROSEWOOD GREEN ESTATE"  
STAGE 1A

DRAWING TITLE  
AS-CONSTRUCTED SERVICES  
LOTS 290-294

REV	DATE	APPROVED:
		<i>Daniel Michel</i>
		DANIEL MICHEL RPEQ 3766 DIRECTOR HUNT MICHEL & PARTNERS

DESIGNED: D.M.  
DRAWN: N.K.  
CHECKED: D.M.  
SCALE: 1:500 AT A3  
DATE:

JOB No.  
208025  
DWG No.  
AC2

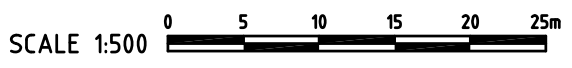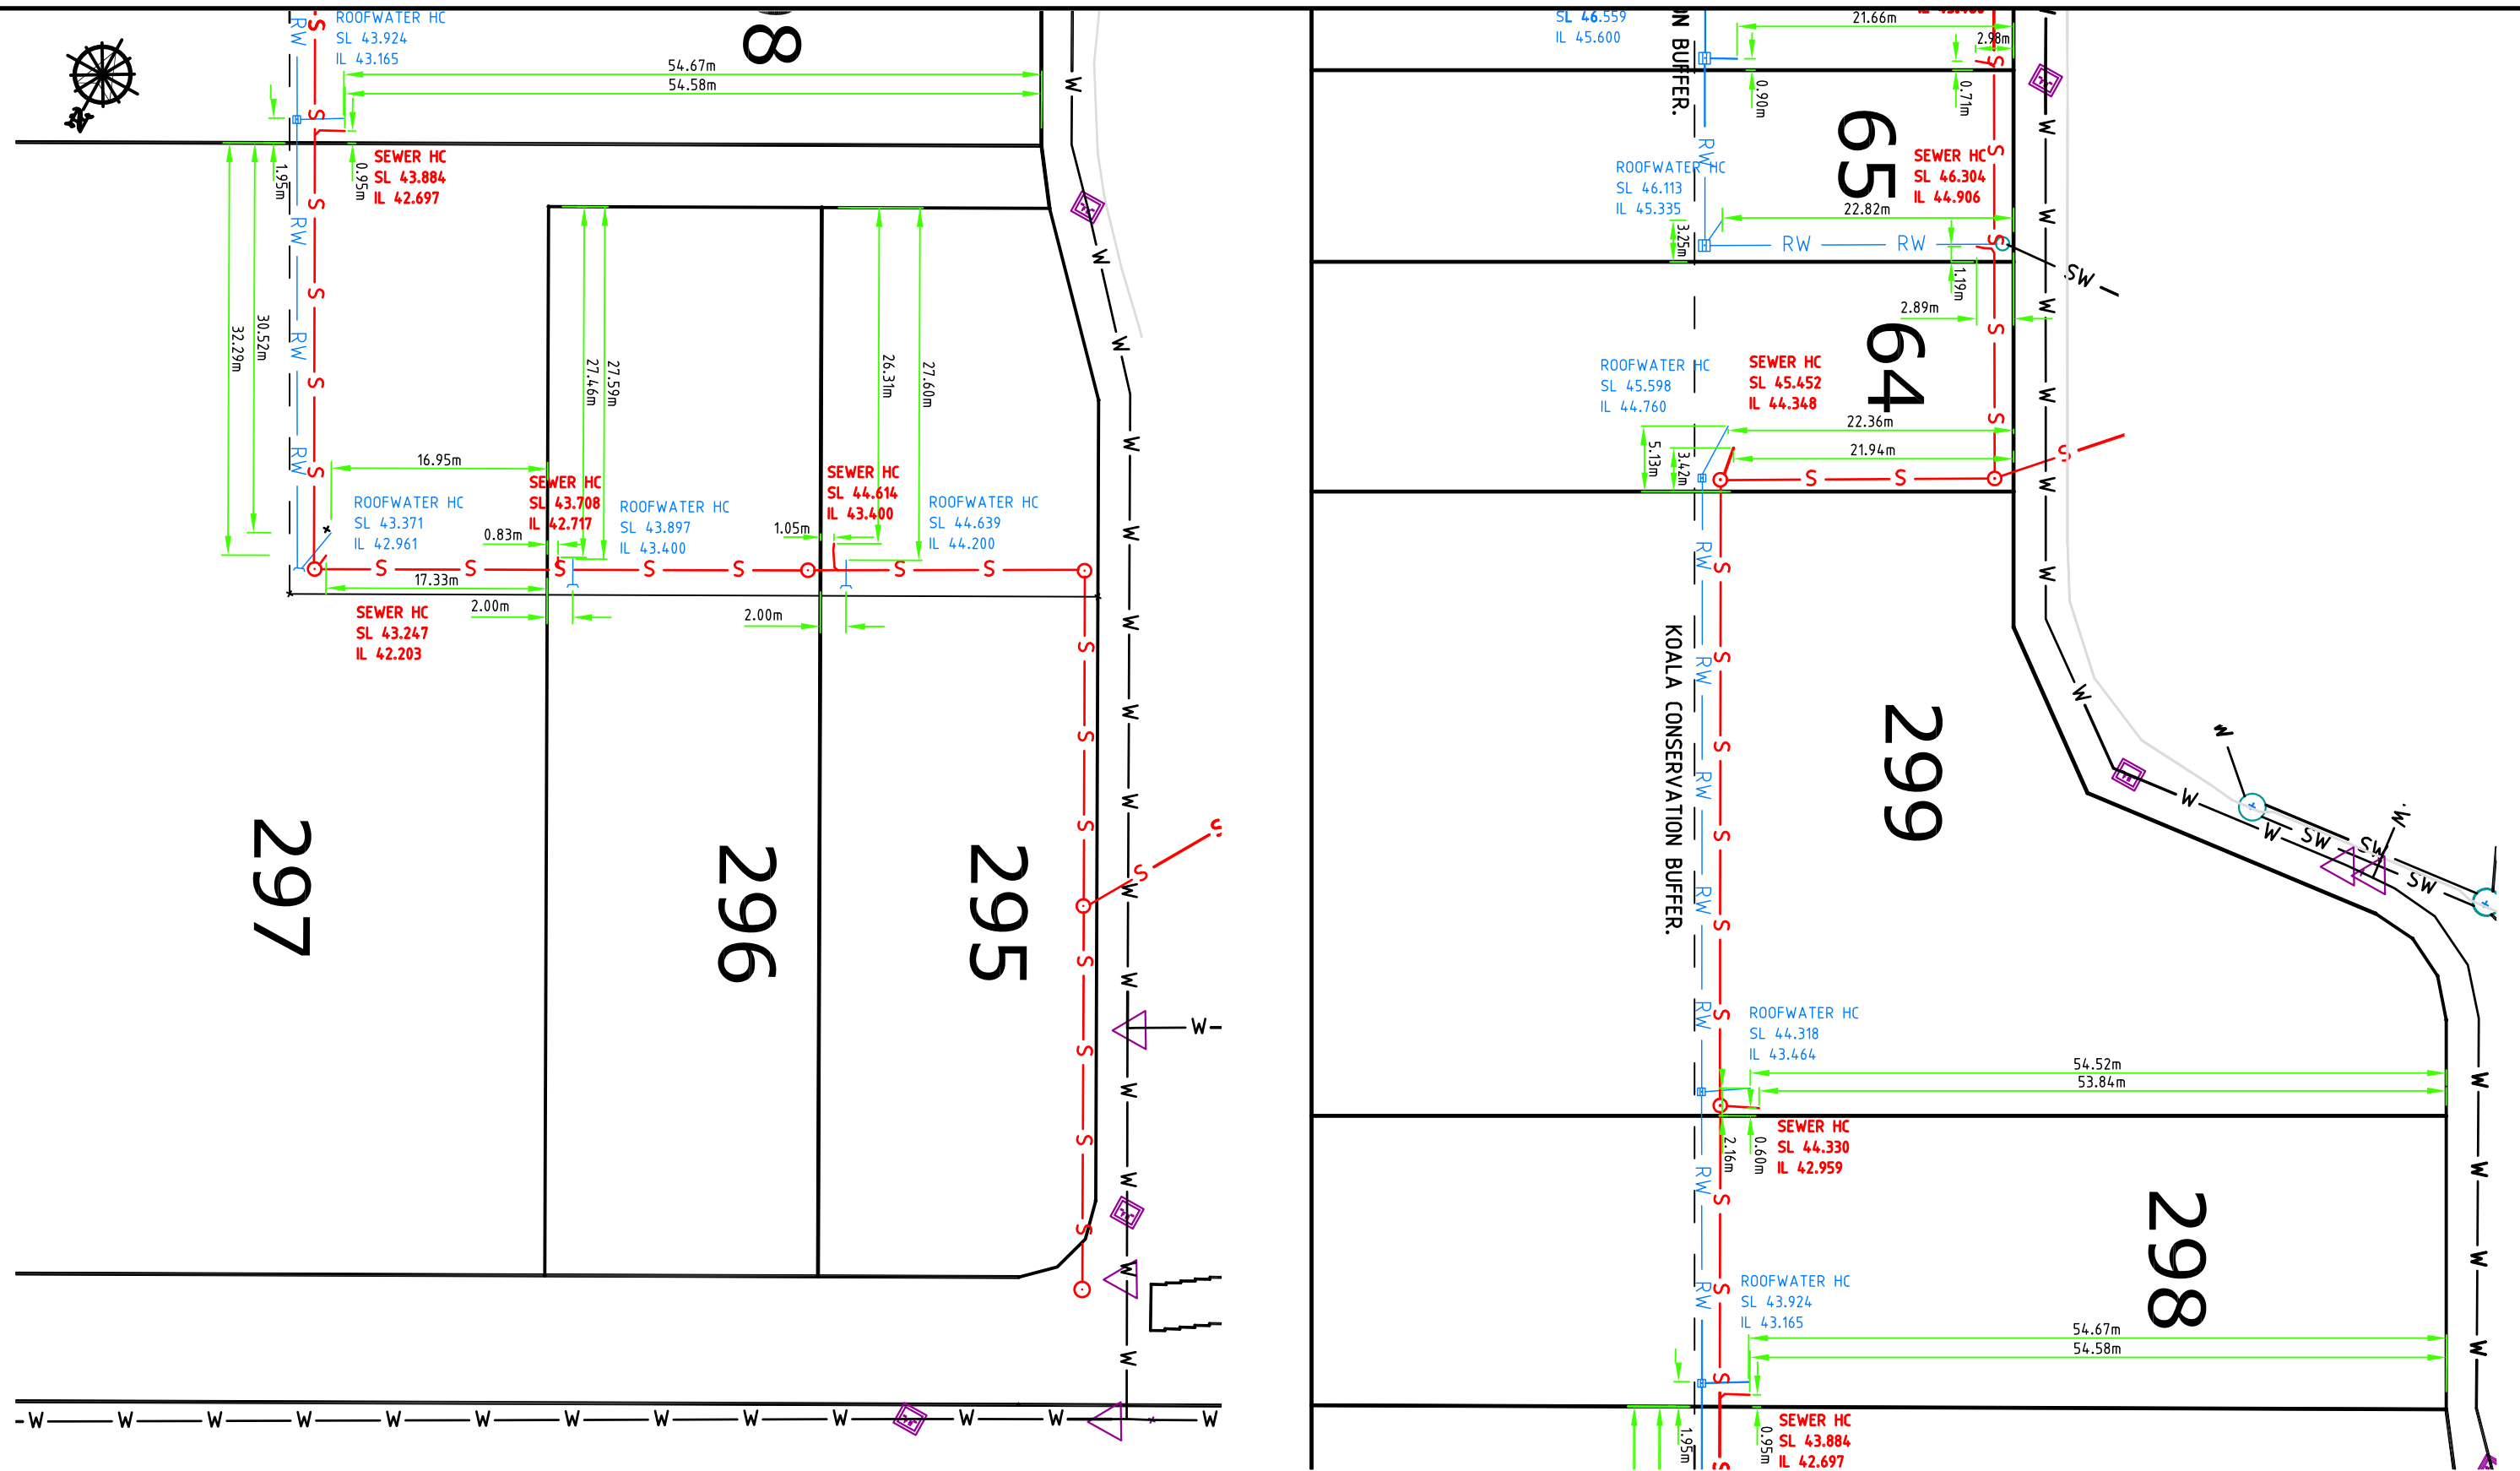

**HUNT MICHEL & PARTNERS**  
 24 DARLING STREET  
 IPSWICH Q 4305  
 PH 3812 2399  
 CONSULTING CHARTERED ENGINEERS  
 CIVIL AND STRUCTURAL  
 A.B.N. 75 074 746 599

CLIENT  
 ROSEWOOD GREEN PROPERTY  
 PO BOX 3715  
 ROUSE HILL NSW 2155

PROJECT  
 "ROSEWOOD GREEN ESTATE"  
 STAGE 1A

DRAWING TITLE  
 AS-CONSTRUCTED SERVICES  
 LOTS 295-299

REV	DATE	APPROVED:
		<i>Daniel Michel</i>
	23.17	DANIEL MICHEL RPEQ 3766 DIRECTOR HUNT MICHEL & PARTNERS

DESIGNED: D.M.  
 DRAWN: N.K.  
 CHECKED: D.M.  
 SCALE: 1:500 AT A3  
 DATE:

JOB No.  
 208025  
 DWG No.  
 AC1