



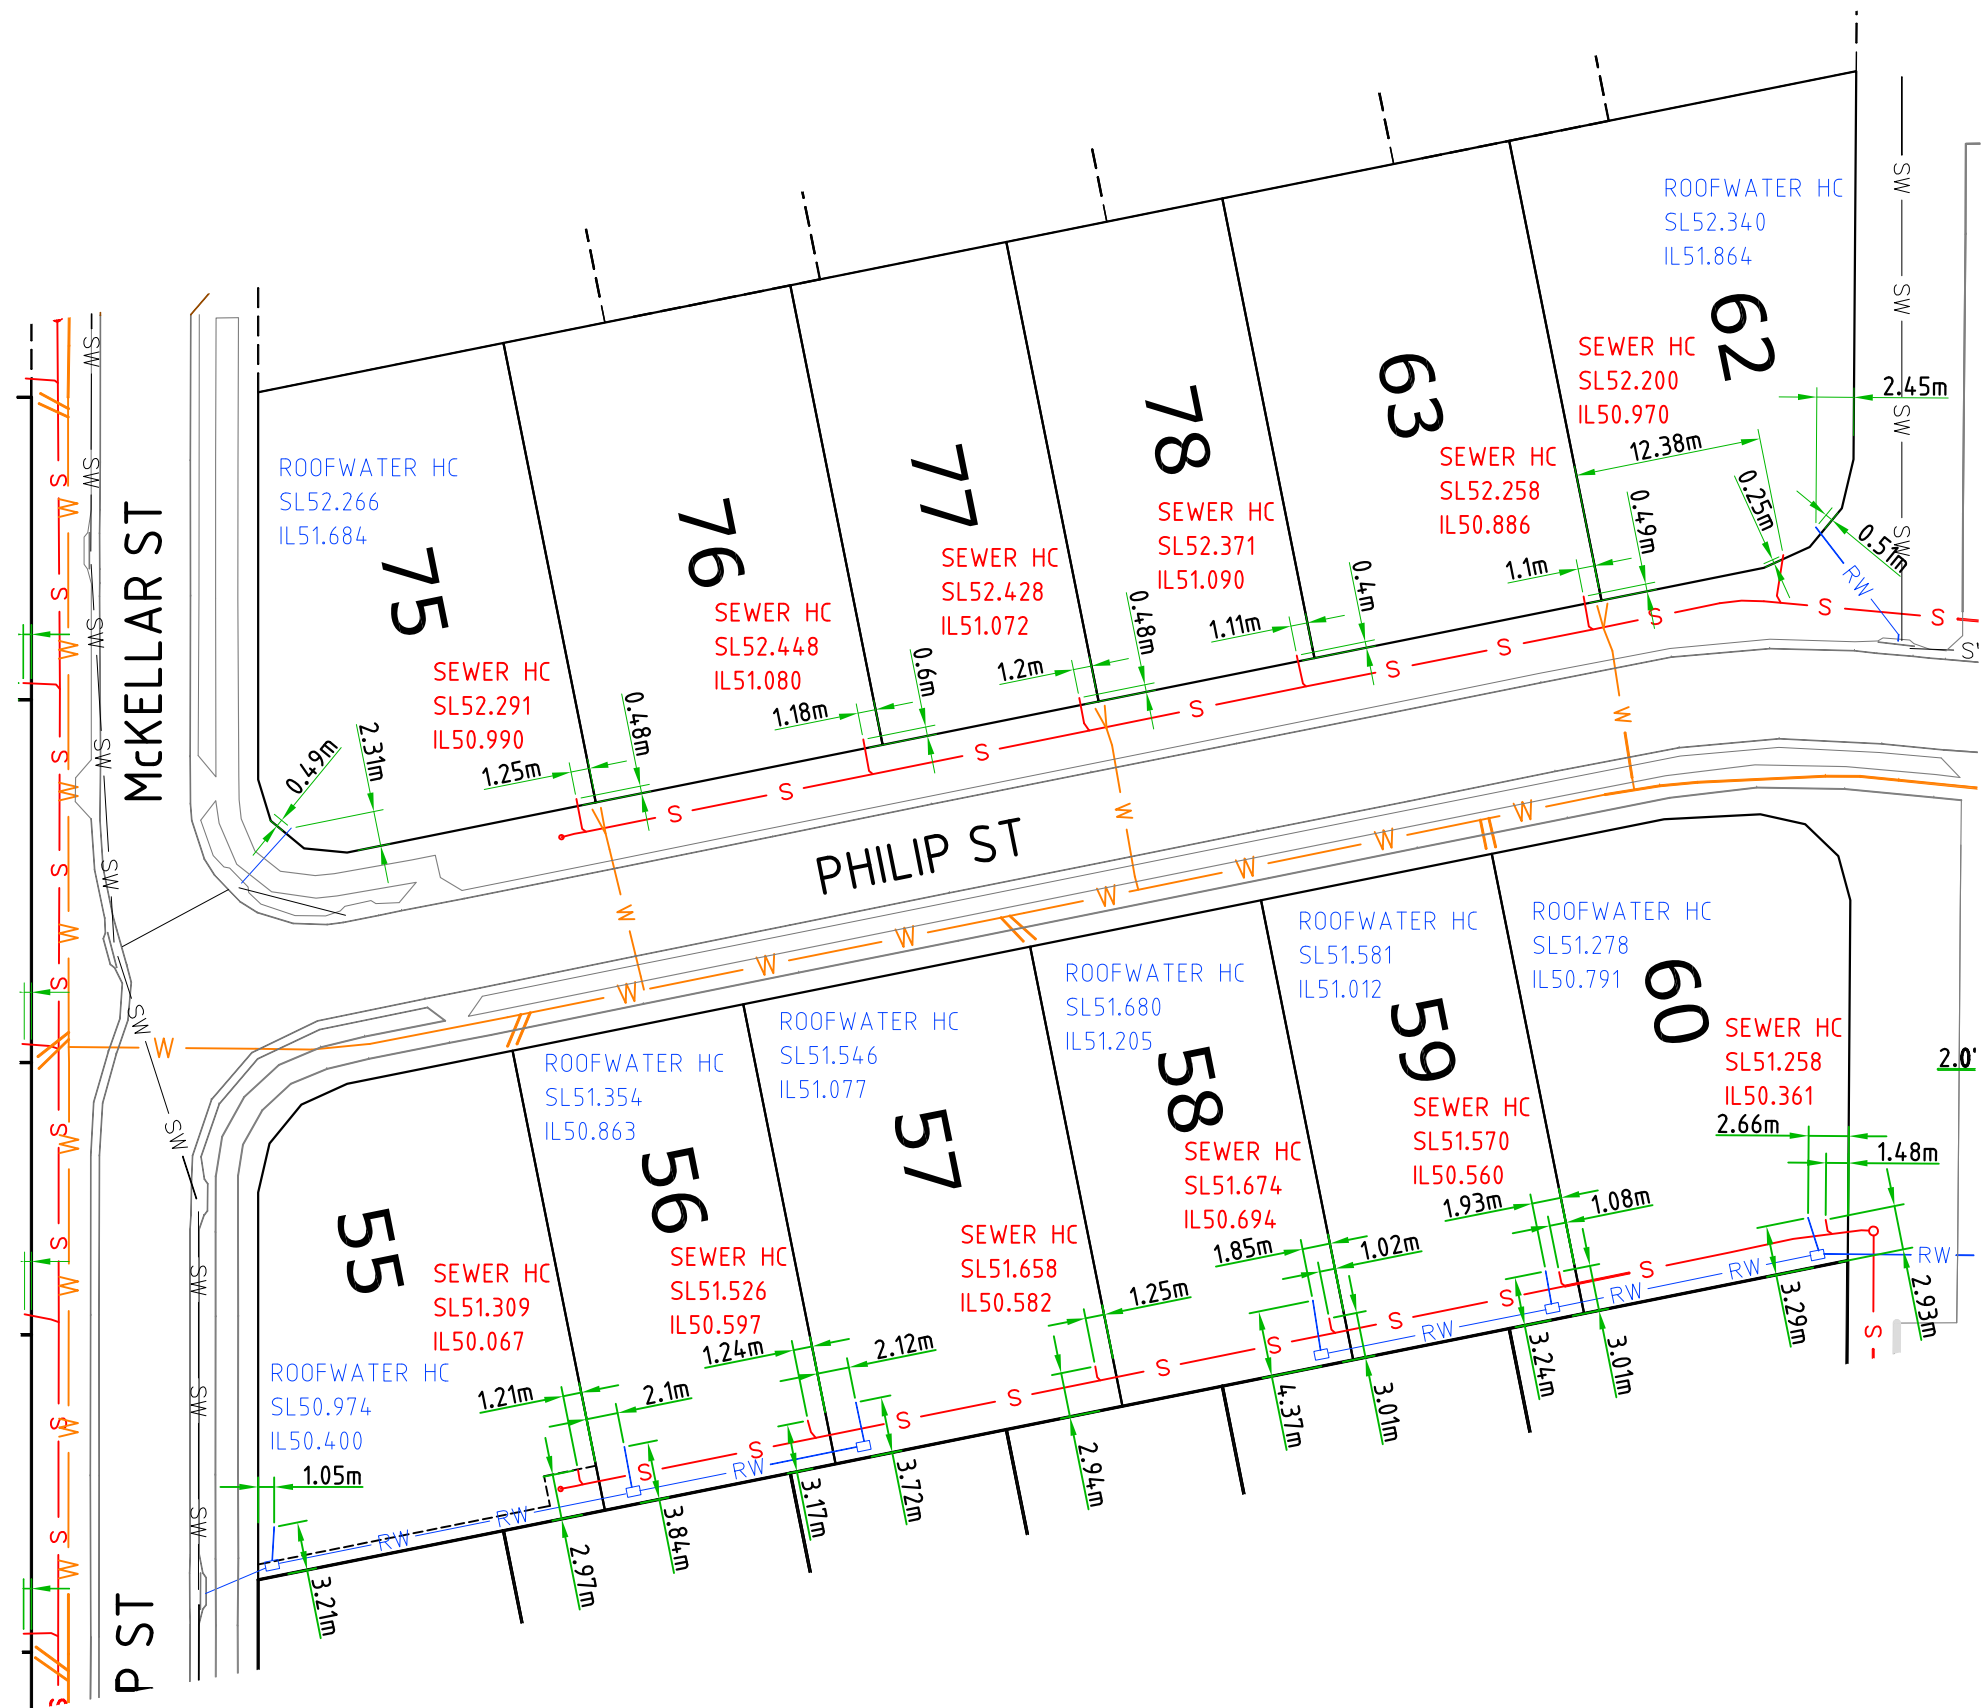

PHILIP ST

OB No.
216006

WG No.
AC1

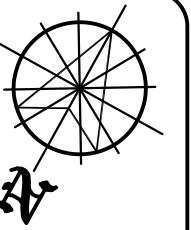

SCALE 1:500 0 5 10 15 20 25m

HUNT MICHEL & PARTNERS

Postal Address:
24 DARLING STREET
IPSWICH Q 4305

CONSULTING ENGINEERS
CIVIL AND STRUCTURAL
A.B.N. 75 074 746 599

PH 3812 2399
FAX 3812 1900
EMAIL dan@hmengineers.com.au




CLIENT
ROSEWOOD GREEN PROPERTY
PO BOX 3715
ROUSE HILL NSW 2155

PROJECT
ROSEWOOD GREEN ESTATE
STAGE 1B
ROSEWOOD QLD 4340

DRAWING TITLE
AS-CONSTRUCTED SERVICES
LOTS 55-60, 62-63, 75-78

REV	DATE	APPROVED:
A	02.06.20	Daniel Michel DIRECTOR, HUNT MICHEL & PARTNERS

DESIGNED: N.K.	JOB No.
DRAWN: N.K.	216006
CHECKED: D.M.	DWG No.
SCALE: 1:500 AT A3	AC3
DATE:	

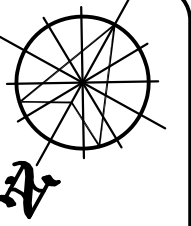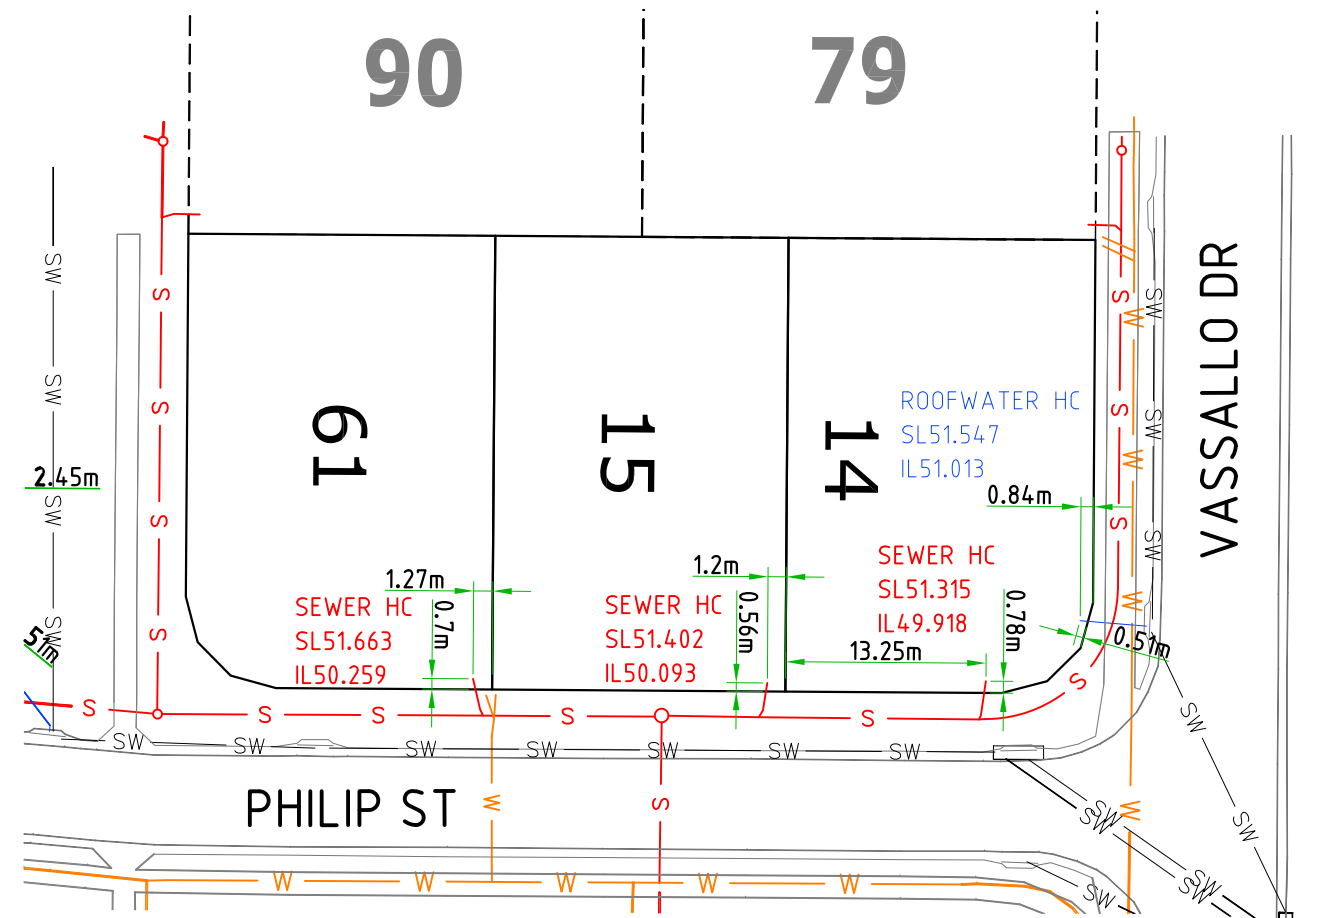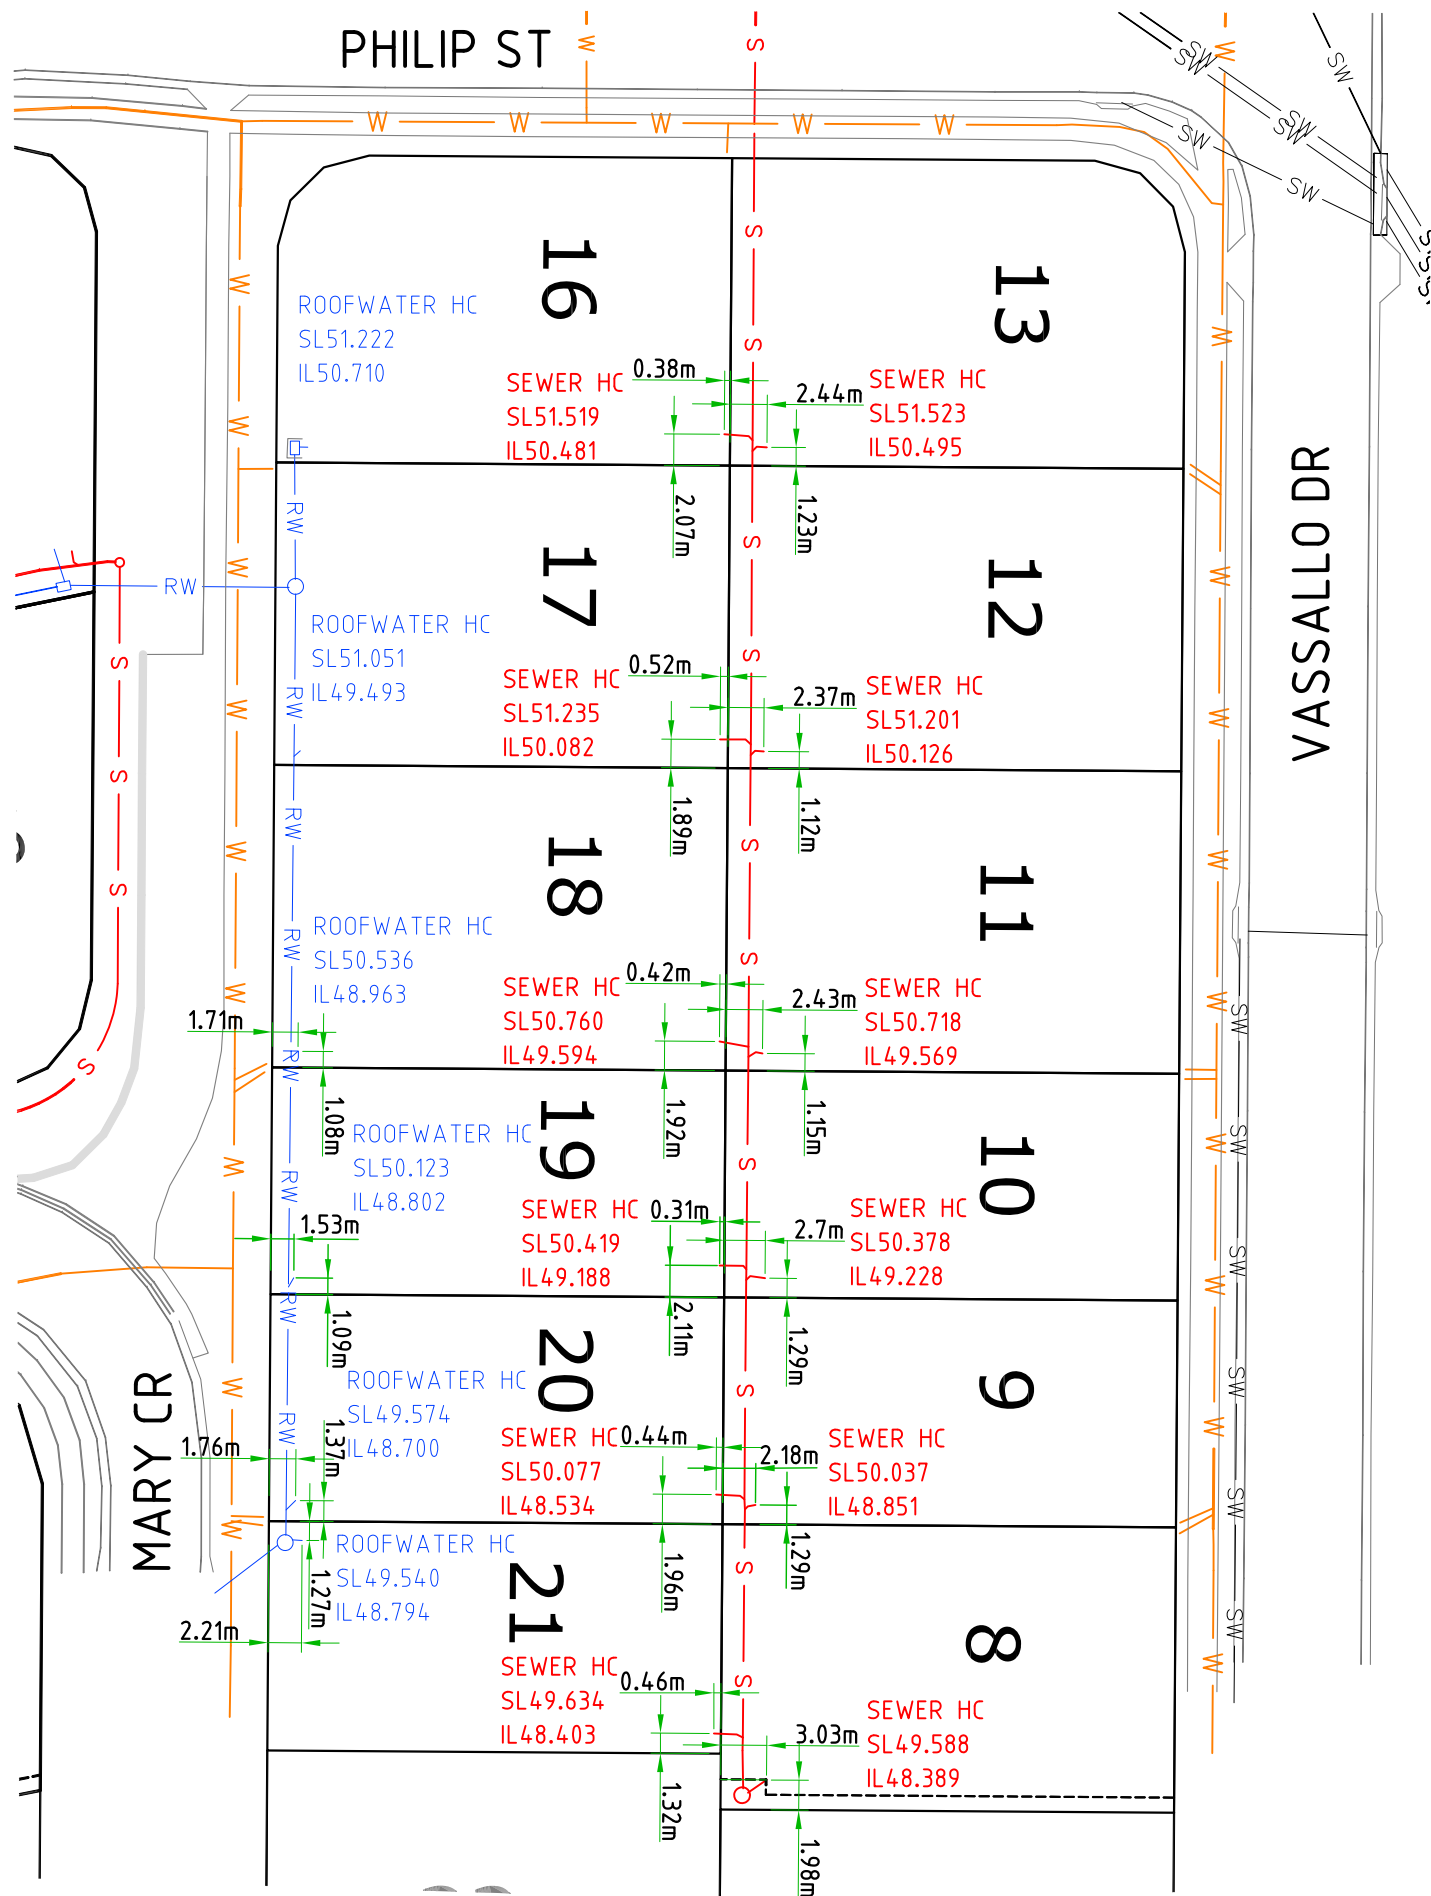

SCALE 1:500 0 5 10 15 20 25m

HUNT MICHEL & PARTNERS

Postal Address: 24 DARLING STREET IPSWICH Q 4305
 CONSULTING ENGINEERS CIVIL AND STRUCTURAL A.B.N. 75 074 746 599
 PH 3812 2399 FAX 3812 1900 EMAIL dan@hmengeers.com.au

CLIENT
 ROSEWOOD GREEN PROPERTY
 PO BOX 3715
 ROUSE HILL NSW 2155

PROJECT
 ROSEWOOD GREEN ESTATE
 STAGE 1B
 ROSEWOOD QLD 4340

DRAWING TITLE
 AS-CONSTRUCTED SERVICES
 LOTS 8-21, 61

REV	DATE	APPROVED:
A	AS CONSTRUCTED	02.06.20

DANIEL MICHEL RPEQ 3766
 DIRECTOR, HUNT MICHEL & PARTNERS

DESIGNED: N.K.
 DRAWN: N.K.
 CHECKED: D.M.
 SCALE: 1:500 AT A3
 DATE:

JOB No.
216006
 DWG No.
AC4